


SLD - Drawing not to scale,
For information purposes only.
Not for construction.

Notes:

This is a revised version of GDS drawing:
GDS-0212-2-S001
The order of generators 11-14 have been
reversed, and the output of generator 14 has
been corrected from 2000kwp to 1900kwp

Issue Log:

Issue:	Revision Details:	Date:
01	Initial Issue	13/07/2017

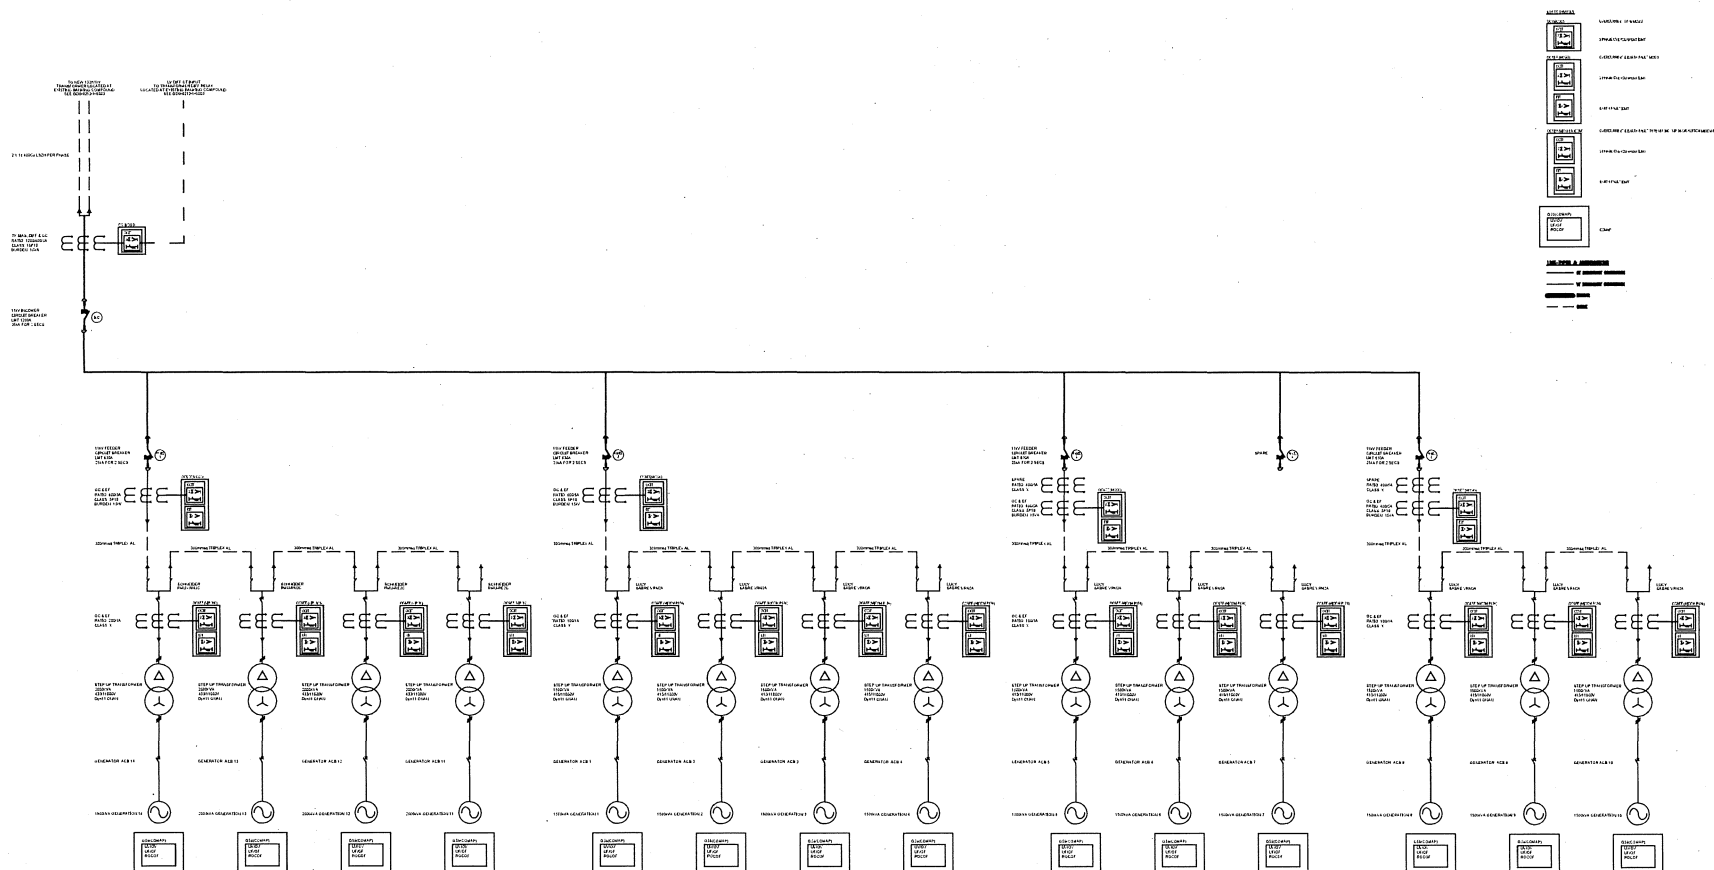

SKYFALL ENERGY

Skyfall Energy Ltd
Thorncombe Barn
Fore Street
Thorncombe
Dorset TA20 4PP

Phone: [REDACTED]
www.skyfall-energy.com

Project Name:

SIMEC Uskmouth
Power Station (SUP)

Document Name:

Single Line Diagram
As Built

Document Reference #:

102-04-07

Scale: NTS@A3

Issue: 01

Produced:
RC

Checked:
##

Date:
13/07/2017